


PLUG	PIN	WIRE NO	WIRE COLOR
PJ2021	1	2021	Y
PJ2021	2	2861	RD
PJ2021	3	2522	GR
PJ2021	4	SP	RD/BLU
PJ2021	5	1101	BLU
PJ2021	6	2022	GN
PJ2021	7	1072	BN
PJ2021	8	1018	WH/GR
PJ2021	9	0015	WH/GR
PJ2021	10	1010	WH/GR
PJ2021	11	1019	BK
PJ2021	12	GRND	GR/YE
PJ2021	13	1012	YW/BN
PJ2021	14	0101	BN/GR
PJ2021	15	SP	WH
PJ2021	16	SP	YE
PJ2021	17	SP	PK
PJ2021	18	SP	GR/BN
PJ2021	19	SP	GR/PK

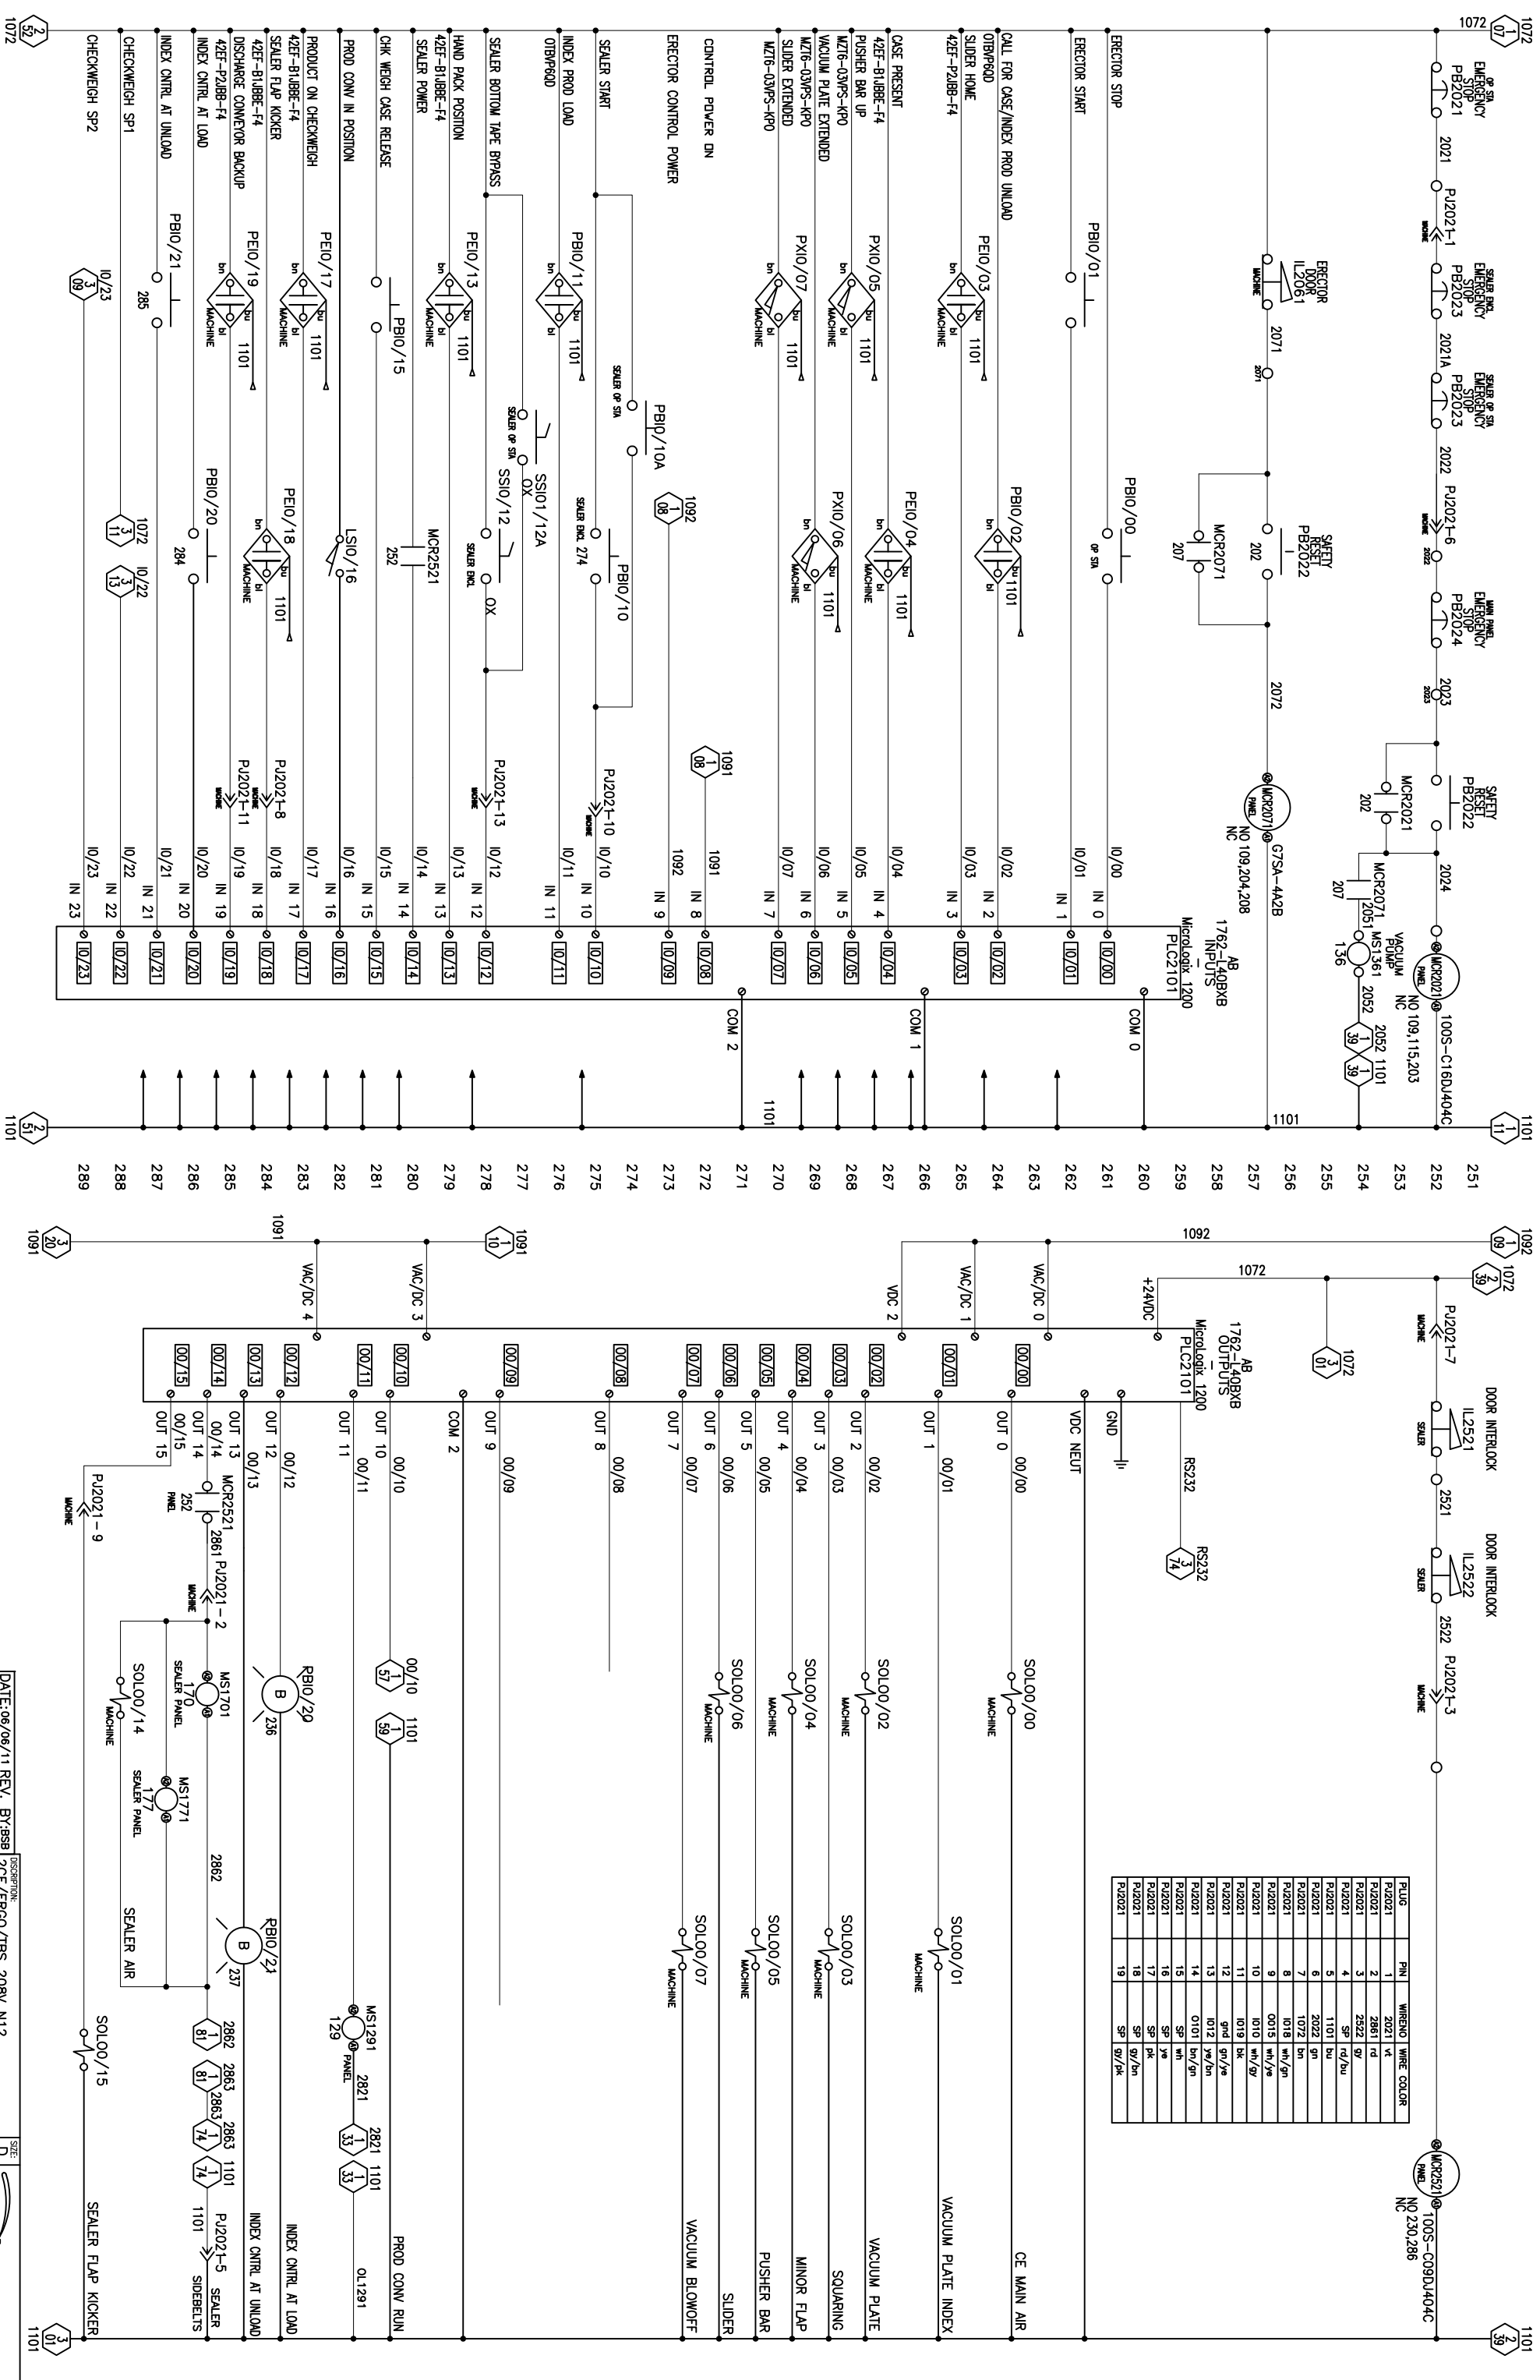

DATE: 06/06/11 REV. BY: 88SB ZCE/ERGO/TBS 208V N12  
 SHOP AS BUILT  
 DISCREPANCY: ZCE/ERGO/TBS 208V N12  
 THESE DRAWINGS TO BE REPRODUCED OR COPIED WITHOUT CONSENT FROM COMBI PACKAGING SYSTEMS  
 DRAWING NUMBER: 2CE07221353  
 SIZE: D  
 SHEET: 2 OF 3